


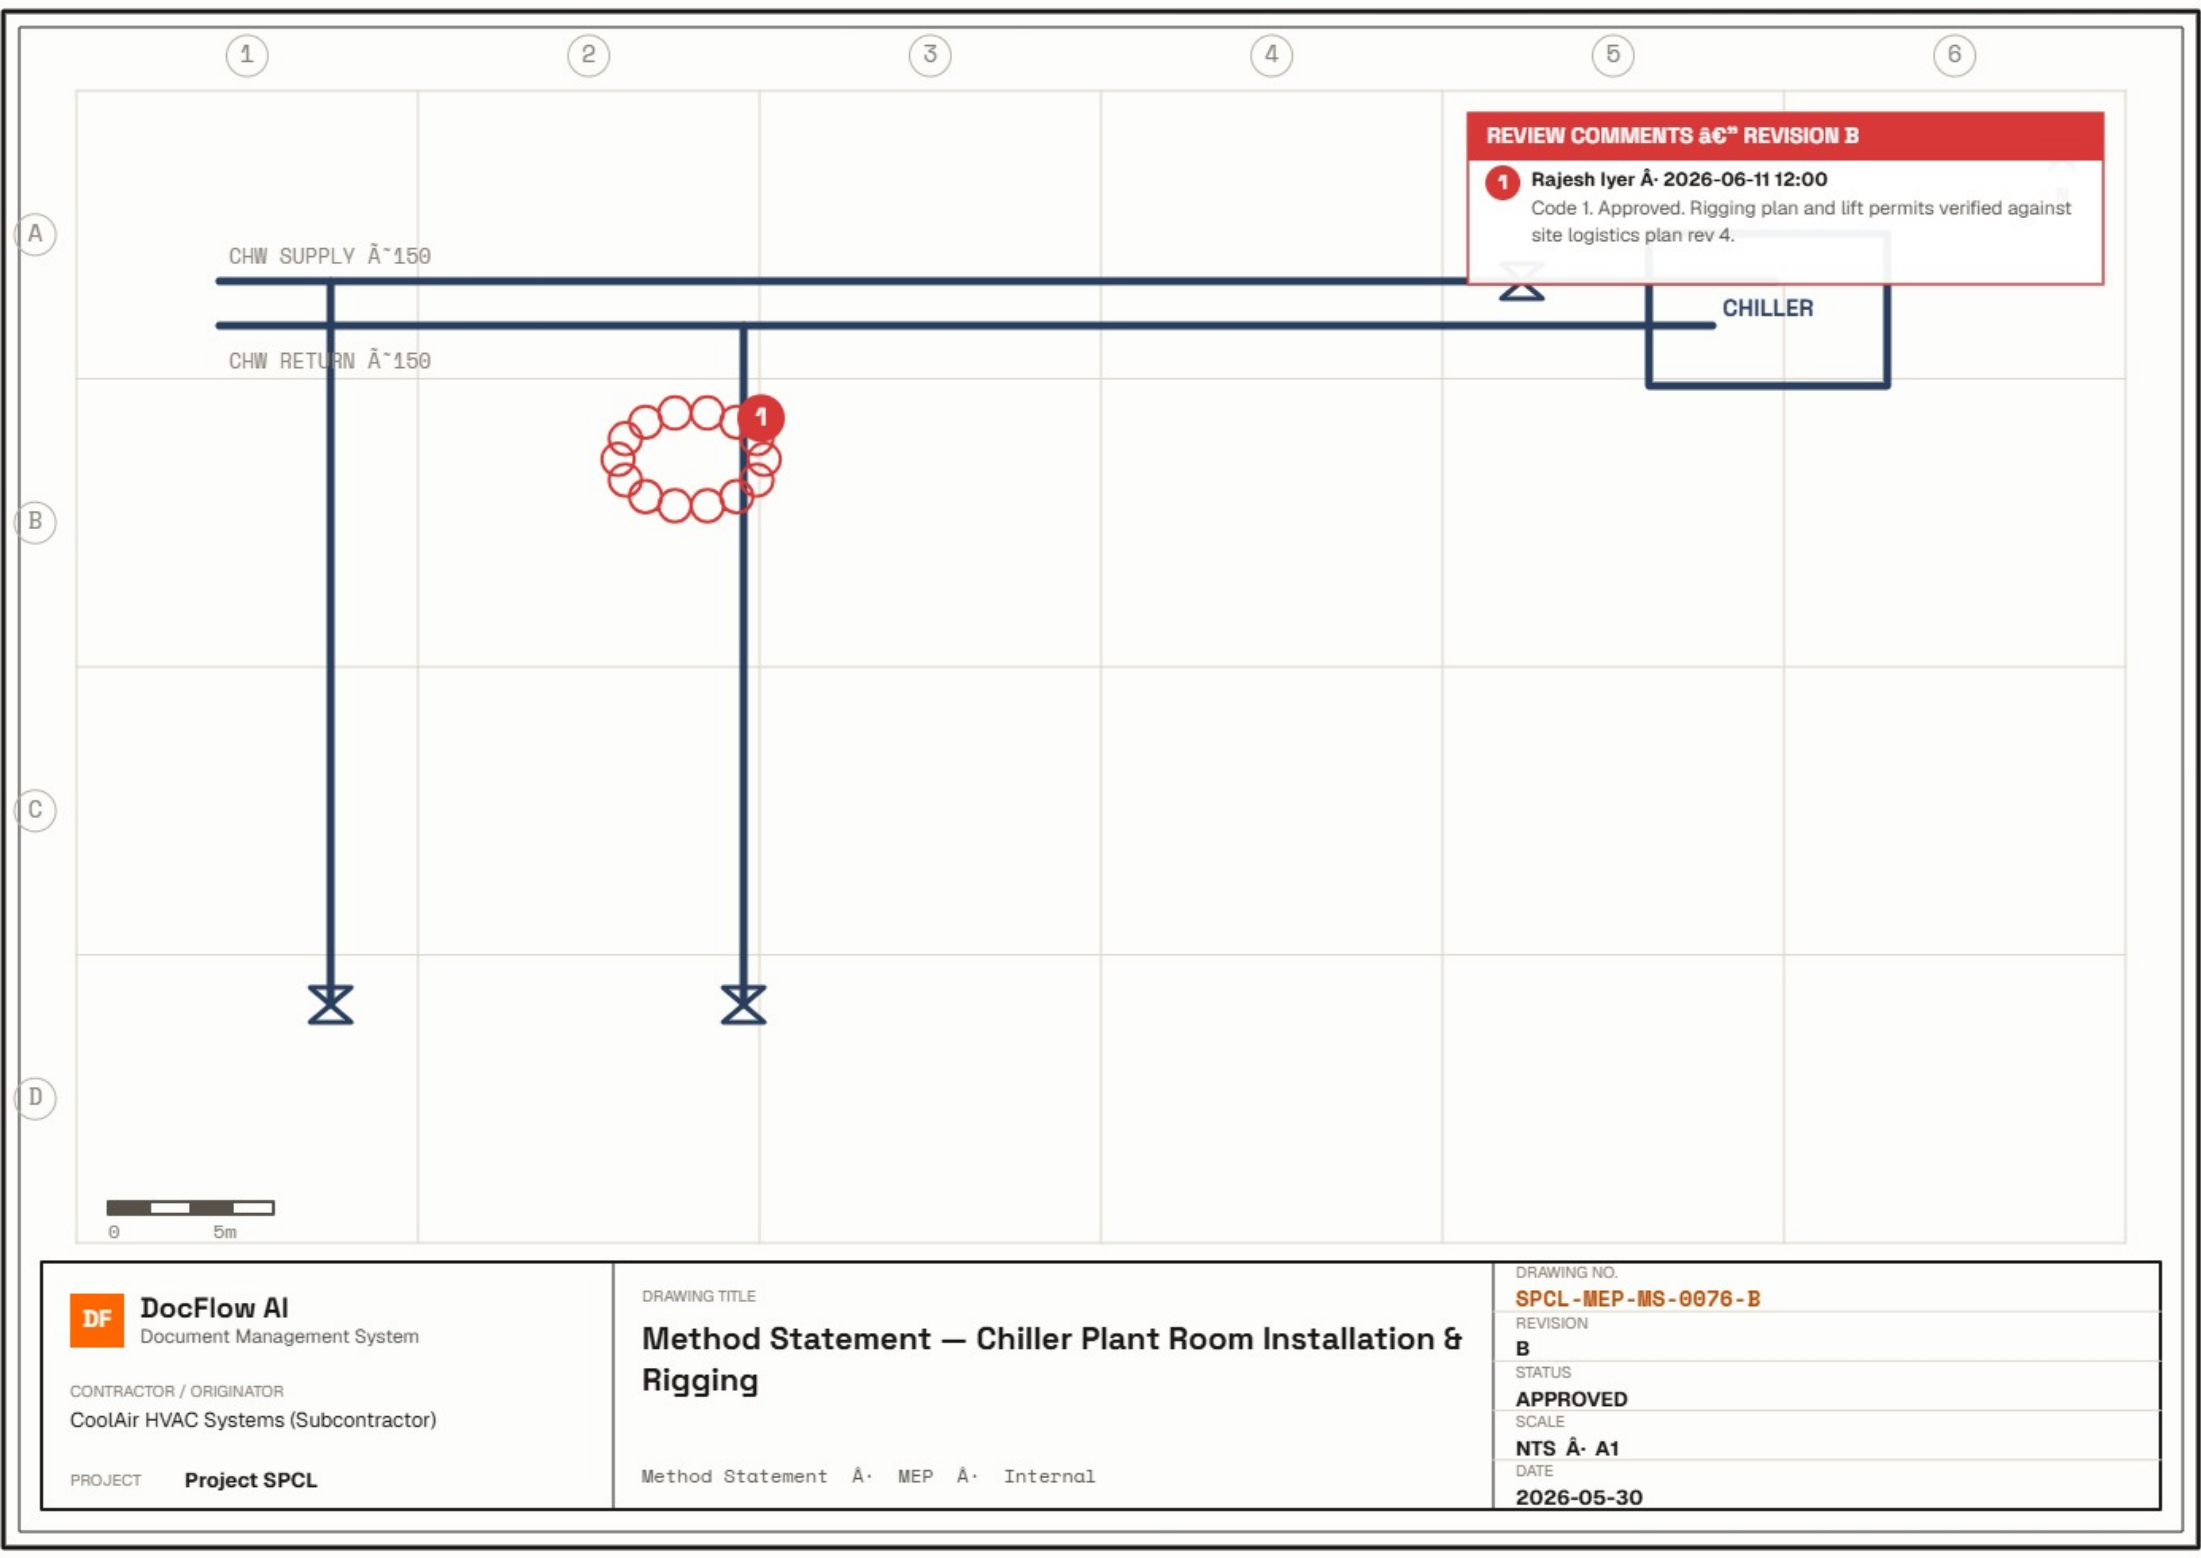

1

2

3

4

5

6

A

B

C

D

CHW SUPPLY ~150

CHW RETURN ~150

CHILLER

REVIEW COMMENTS & REVISION B

1

Rajesh Iyer · 2026-06-11 12:00
Code 1. Approved. Rigging plan and lift permits verified against site logistics plan rev 4.



DocFlow AI
Document Management System

CONTRACTOR / ORIGINATOR
CoolAir HVAC Systems (Subcontractor)

PROJECT **Project SPCL**

DRAWING TITLE

Method Statement – Chiller Plant Room Installation & Rigging

Method Statement · MEP · Internal

DRAWING NO.	SPCL-MEP-MS-0076-B
REVISION	B
STATUS	APPROVED
SCALE	NTS · A1
DATE	2026-05-30