

1

2

3

4

5

6

A


B

C

D

REVIEW COMMENTS & REVISION A

- 1 Meena Krishnan A 2026-07-09 14:20
Code 2. Approved with comments: add setting-out tolerance note ($\pm 3\text{mm}$) per structural consultant email of 05-Jul; grout spec reference to be updated to rev 2 of STR-SPC-0012.

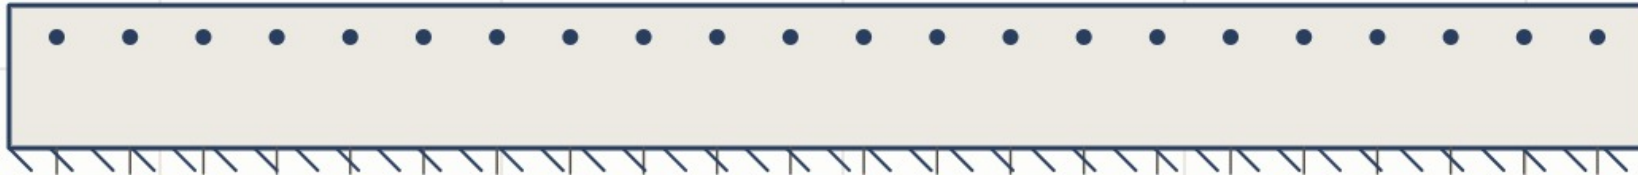

T20 @ 150 c/c @ span 1030 (NTS)



DF DocFlow AI
Document Management System

CONTRACTOR / ORIGINATOR
SP Engineering (Main Contractor)

PROJECT **Project SPCL**

DRAWING TITLE

**Anchor Bolt Layout – Podium Transfer Truss
Supports**

Drawing A STR A Internal

DRAWING NO.

SPCL-STR-DWG-0623-A

REVISION

A

STATUS

APPROVED W/ COMMENTS

SCALE

NTS A A1

DATE

2026-06-28